


PROJECT	NO.	DATE
REVISIONS		
NO.	DESCRIPTION	DATE
1	AS NOTED	
2	AS NOTED	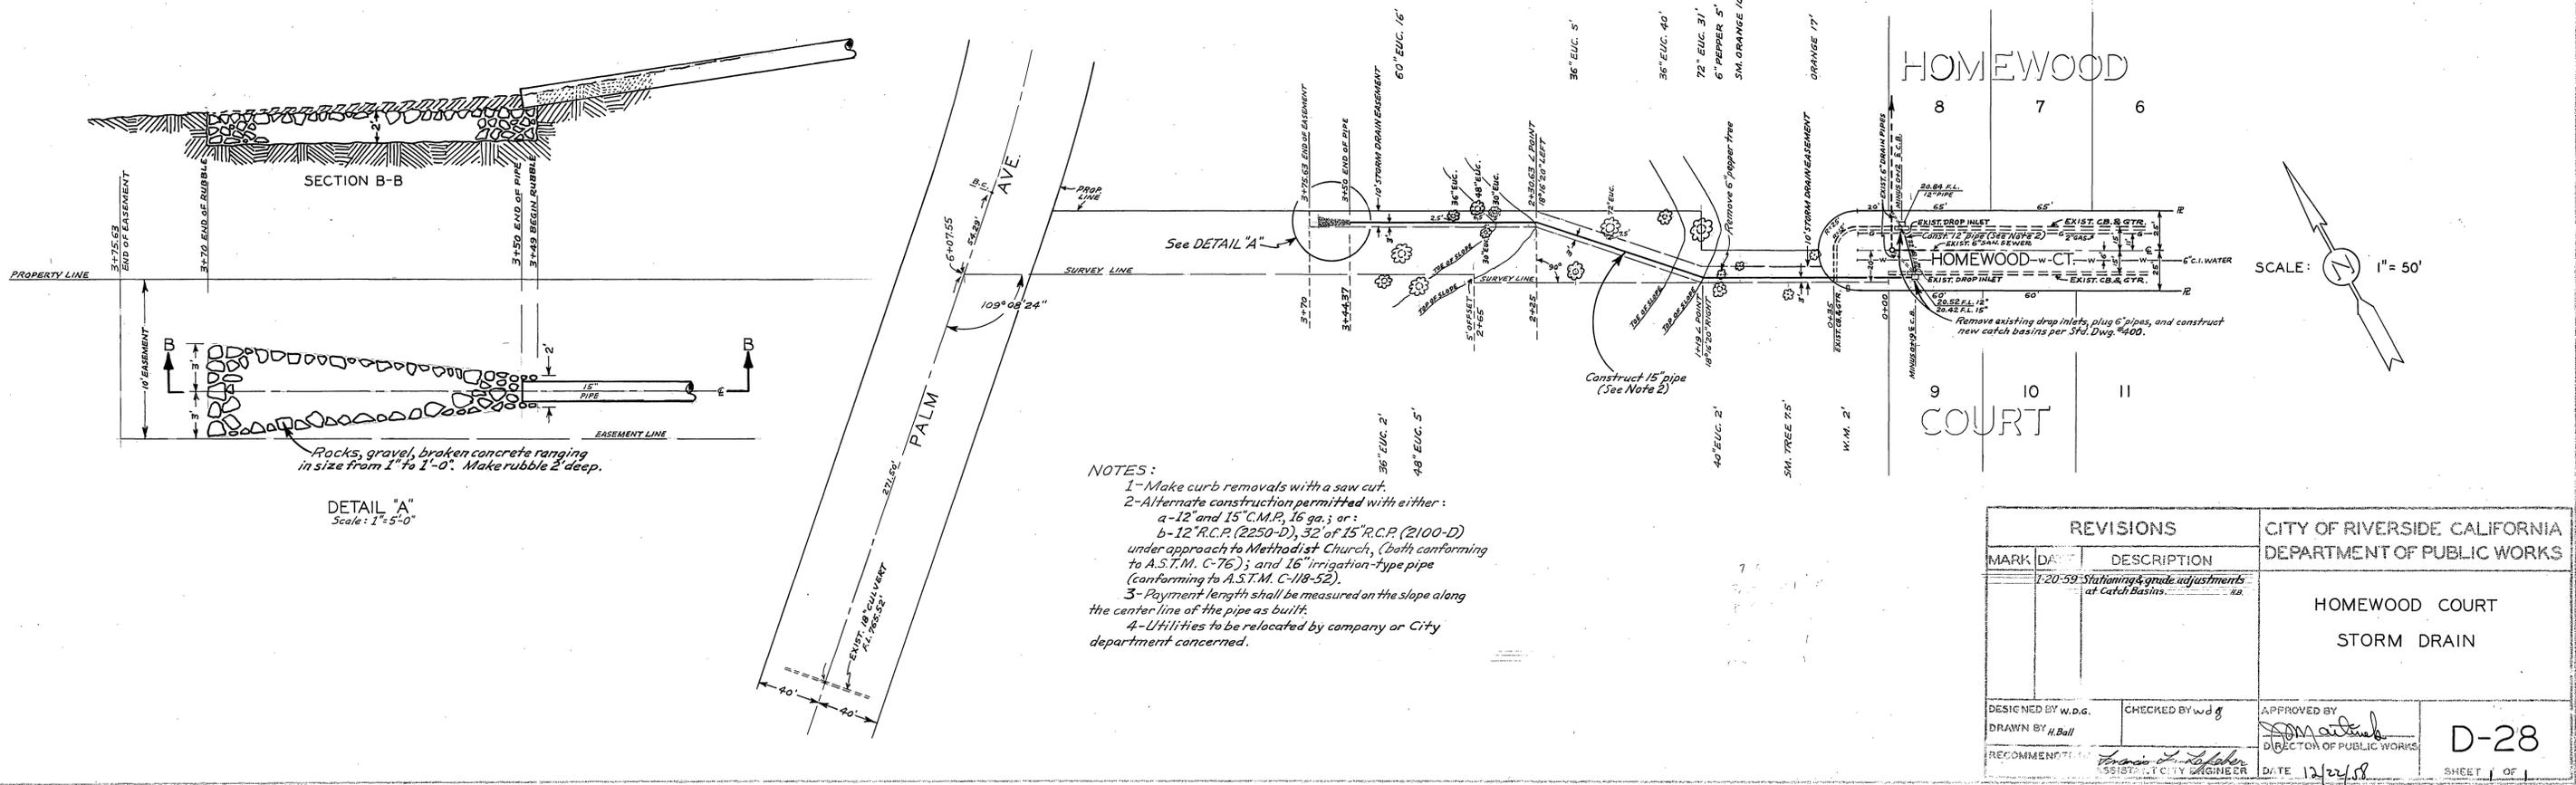
PROJECT	NO.	DATE
REVISIONS		
NO.	DESCRIPTION	DATE
1	AS NOTED	
2	AS NOTED	
3	AS NOTED	
SECTION B-B
Scale: 1" = 5'-0"

DETAIL "A"
Scale: 1" = 5'-0"

- NOTES:
- 1- Make curb removals with a saw cut.
 - 2- Alternate construction permitted with either:
a- 12" and 15" C.M.P., 16 ga.; or:
b- 12" R.C.P. (2250-D), 32 of 15" R.C.P. (2100-D) under approach to Methodist Church, (both conforming to A.S.T.M. C-76); and 16" irrigation-type pipe (conforming to A.S.T.M. C-118-52).
 - 3- Payment length shall be measured on the slope along the center line of the pipe as built.
 - 4- Utilities to be relocated by company or City department concerned.

REVISIONS		CITY OF RIVERSIDE, CALIFORNIA DEPARTMENT OF PUBLIC WORKS			
MARK	DATE				
		HOMECOURT STORM DRAIN			
DESIGNED BY	W.D.G.	CHECKED BY	W.D.G.	APPROVED BY	[Signature]
DRAWN BY	H. Ball	RECOMMENDED BY	[Signature]	DATE	12/27/88
				DIRECTOR OF PUBLIC WORKS	D-28
				ASSISTANT CITY ENGINEER	SHEET 1 OF 1

TOPOGRAPHICAL MAP

FOR FIRST METHODIST CHURCH IN LOTS 178 AND 179, S.C.C.A. LANDS

MAY 1956

J.F. DAVIDSON, C.E.

SCALE 1"=40'

